

KOCH PROCESS SYSTEMS

PROJECT Soc

K.P.S. DWG. NO. SC1-8-049

THIS REVIEW DOES NOT RELIEVE THE SELLER OR CONTRACTOR OF ANY OBLIGATIONS UNDER THE P.O. OR CONTRACT.

☒ FINAL APPROVAL


☐ APP'D. AS NOTED - REVISE & RESUBMIT

☐ APPROVED FOR FABRICATION.

☐ NOT APPROVED - REVISE & RESUBMIT

☐ RELEASED FOR PROCUREMENT OF MATERIALS ONLY

BY [Signature] DATE 4/19/5

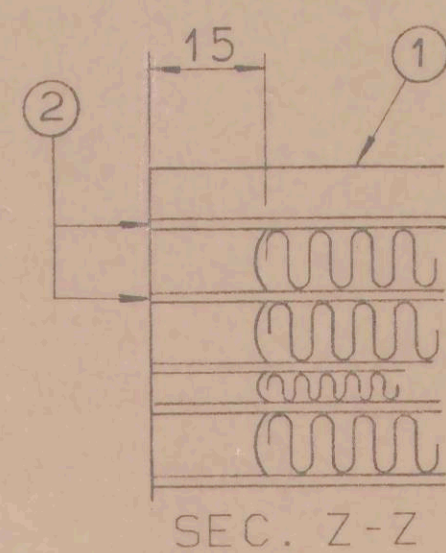

ITEM NO.	R	T	D
(12)	108	6	228
(13)	68	5	146
(14)	58	5	126
(15)	78	5	166

*; HARDWAY FIN
STREAM A1, A2 : 150R1824/25(V. 9 * LENGTH 10mm WARM END

配布先
熱技₁
二生₂
外注
二製
現場
現地
品熱₁
品航
購売
NY₁
參考(生技)
(物流)₁
客先
1FR+1

APR 18 1991

5	Al - 8167
---	-----------