

KOCH PROCESS SYSTEMS

PROJECT *46C*
 K.P.S. DWG. NO. *501-8-051*
 REVIEW BY/DATE *TMC 4/19/91*

☐ PROJ. ENG.
☐ MECHANICAL
☐ STRESS
☐ ELECTRICAL
☐ PROCESS
☐ MFG. ENG.
☐ MANUF.
☐ Q. A.
☐ DRAFTING

OK

KOCH PROCESS SYSTEMS

PROJECT *46C*
 K.P.S. DWG. NO. *501-8-051*

THIS REVIEW DOES NOT RELIEVE THE SELLER OR CONTRACTOR OF ANY OBLIGATIONS UNDER THE P.O. OR CONTRACT.

☒ FINAL APPROVAL
☐ APP'D. AS NOTED - REVISE & RESUBMIT
☐ APPROVED FOR FABRICATION
☐ NOT APPROVED - REVISE & RESUBMIT
☐ RELEASED FOR PROCUREMENT OF MATERIALS ONLY

BY *[Signature]* DATE *4/19/91*

TEST AND DESIGN DATA		UNIT : PSI G (KG/CM ² G)		OP. PRESS UNIT :		CORRUGATION CODE (PROOF TEST RECORD NO.)		NO. OF LAYERS
STREAM	FLUID	DESIGN PRESS.	DESIGN TEMP.	LEAK TEST	HYDRO TEST	MAIN	DISTRIBUTOR	
A1	HP HE	300 (21.1)	-452/150 (4/338)	330 (23.3)	450 (31.7)	3,948	* 150S1808 (V16)	21/0
A2	HP HE					3,948		0/21
C	LF HE	150 (10.6)		165 (11.7)	225 (15.9)	1,118	* 350S1808(V11) 350R0624/5(V6)	22


* : HARDWAY FIN
 STREAM A1, A2 : 150R1824/10(V121) X LENGTH 10mm BOTH END
 STREAM C : 350R1224/25(V83) X LENGTH 10mm COLD END (SEC.1)

ISSUE	DATE	APPRO.
(A)	<i>7.5 MAR-91</i>	<i>[Signature]</i>

- NOTES
1. ASSEMBLY : MATERIALS OF METAL PARTS ARE ALUMINUM AND ALUMINUM ALLOY AND BONDED BY VAC. BRAZING AND ARGON ARC WELDING.
 2. APPROX. WEIGHT : 330 KG (EMPTY)
 3. * SHOWS THE LOCATION AT WHICH HEAT EXCHANGER AND CONNECTION PIPES SHALL BE CONNECTED AT SITE. (INDICATED BY SCRIBE MARKS)
 4. PROOF TEST OF CORRUGATION WAS PERFORMED IN ACCORDANCE WITH THE REQUIREMENTS OF PARA.UG-101 OF ASME CODE SEC.VIII DIV.1
 5. ONE(1) NAME PLATE IS ATTACHED TO CORE. (ITEM NO. (23))
 ONE(1) NAME PLATE SHALL BE SHIPPED LOOSE. (ITEM NO. (23))
 6. OTHER TESTS : HELIUM LEAK TEST
 (EXTERNAL AND ALL INTERPASSAGES LEAK TEST)
 ALLOWABLE LEAK RATE : EXTERNAL = 1×10^{-6} mbar - l/s
 INTER PASSAGE = 1×10^{-4} mbar - l/s

7. THERE IS NO ITEM REQUIRED RADIOGRAPHIC INSPECTION.

SPECIFICATIONS	
CODE FOR CONSTRUCTION AND INSPECTION	ASME SEC. VIII DIV.1 1989 EDITION AND 1989 ADDENDA
DETAIL SPEC. FOR INSPECTION	SHS-E-1250
SEALING METHOD FOR SHIPPING	SHS-P-152
STORAGE AND INSTALLATION INSTRUCTION	SHS-P-140
REPAIR METHOD OF DEFECTS	SHS-L-0013
STANDARD OF EDGE PREPARATION	SHS-S-1004
THERMAL PERFORMANCE DATA	STD SH0669 SSR 2833
PACKING SPECIFICATION	SHS-P-1083-G

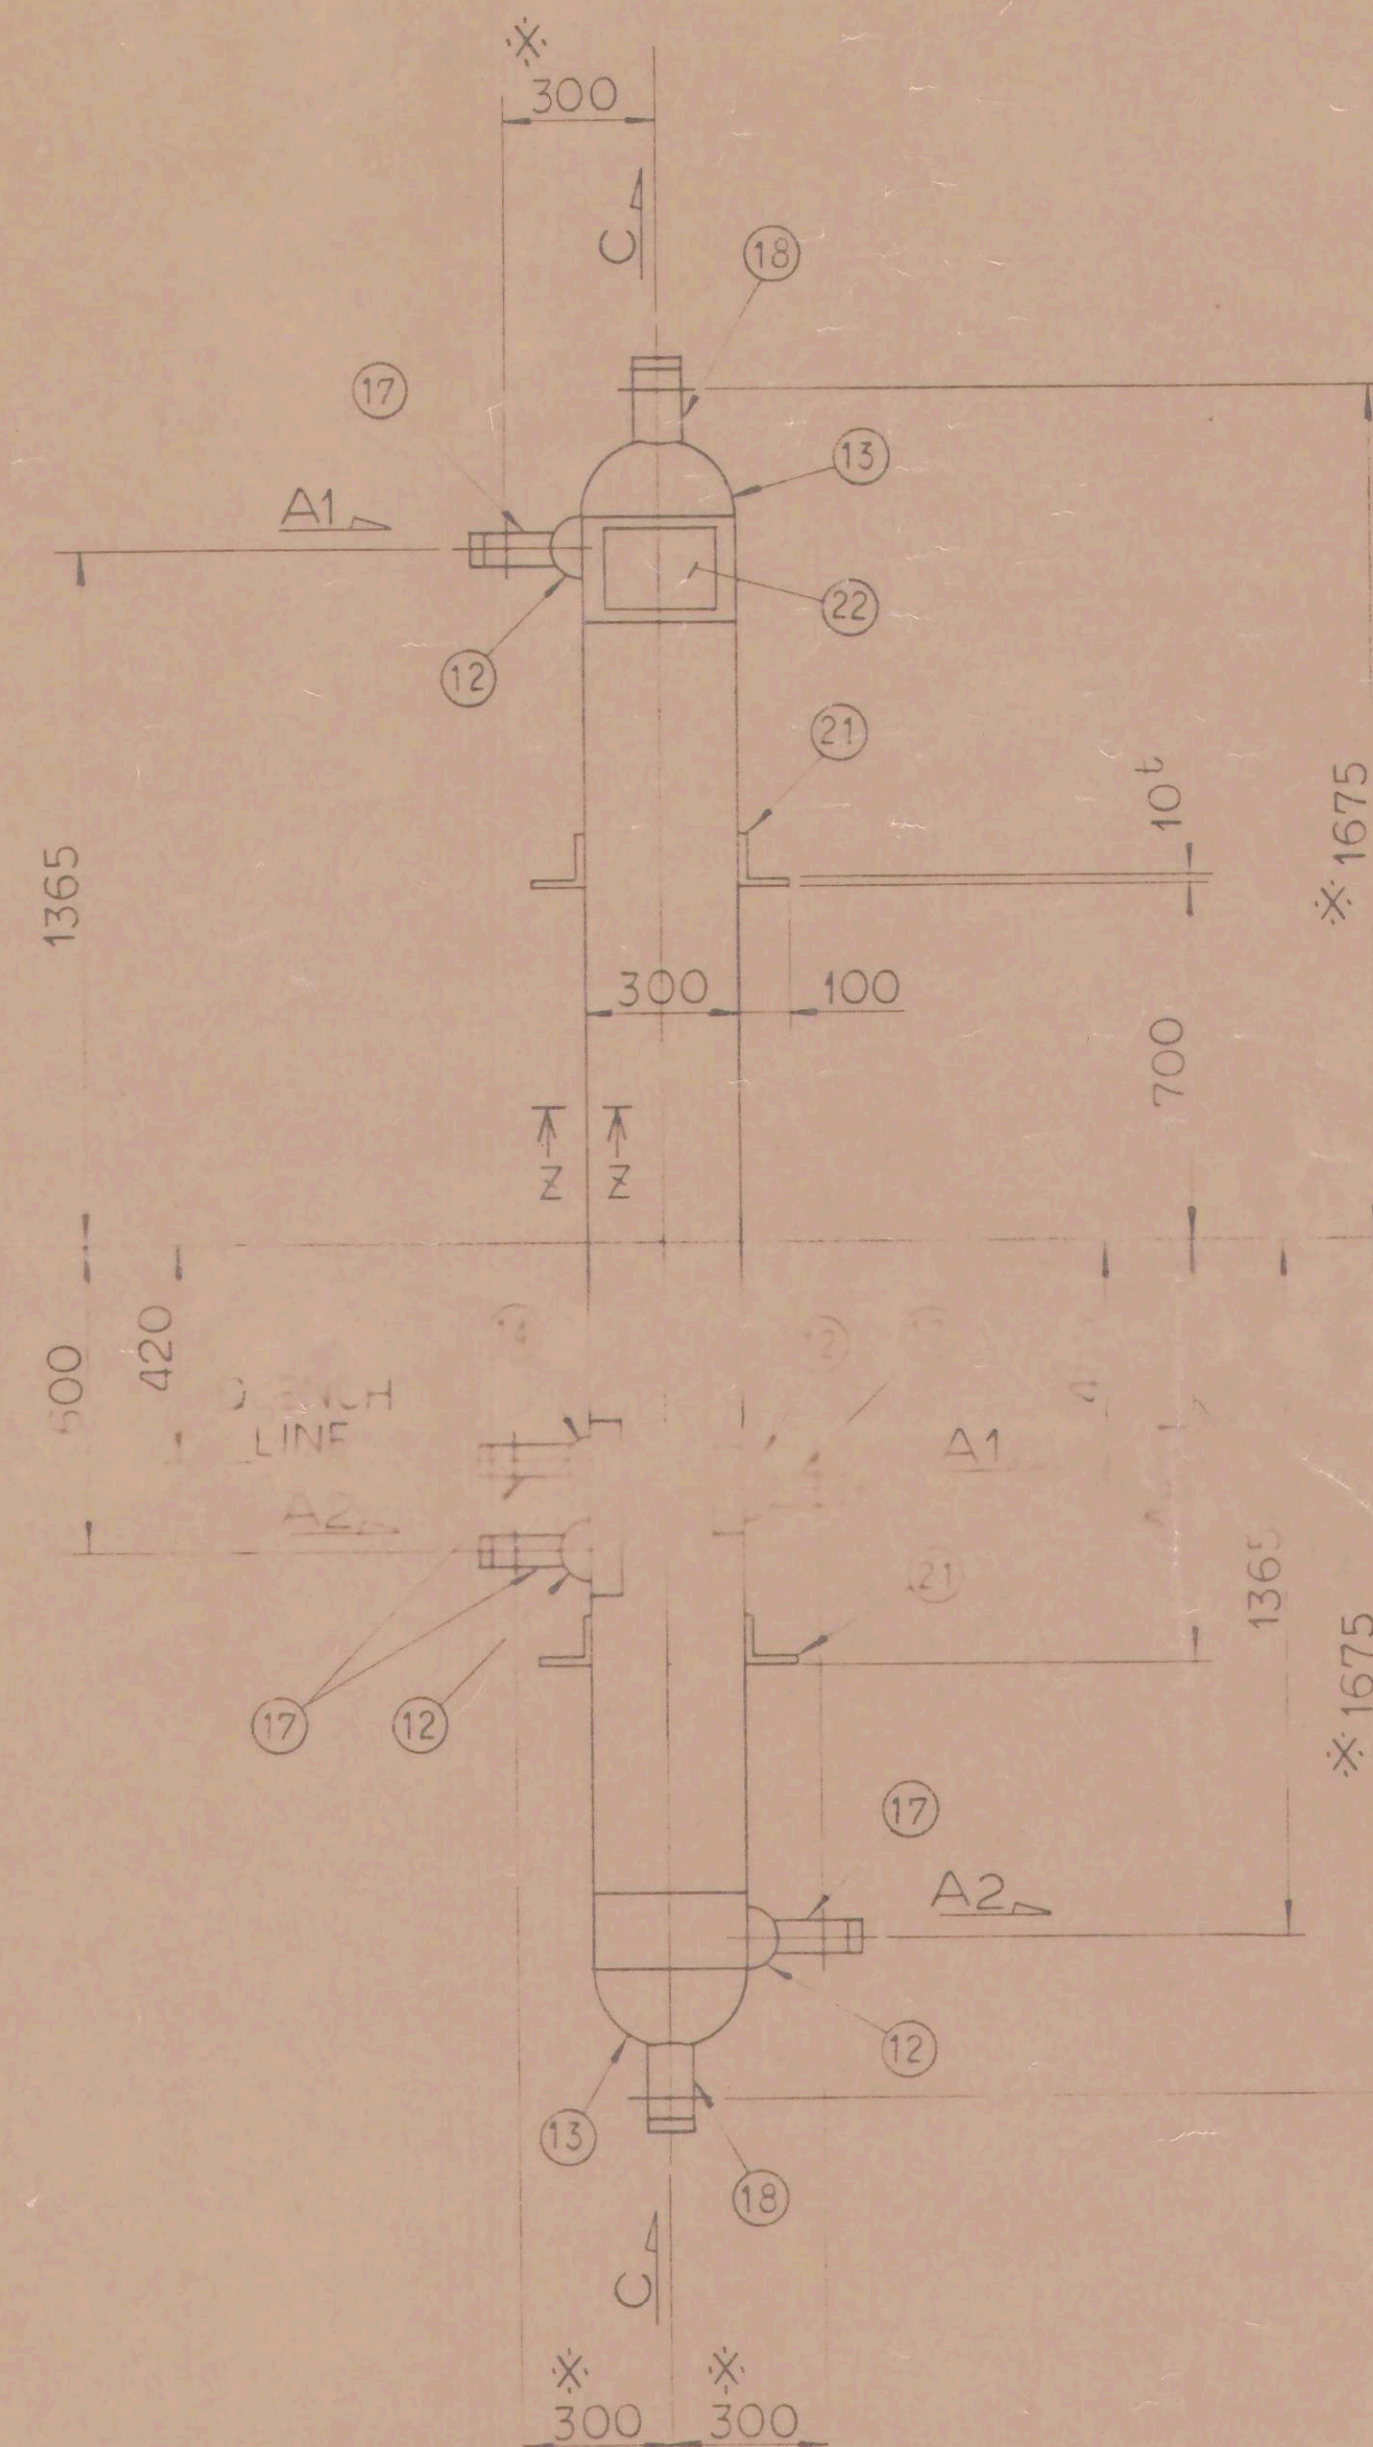


TOP

BOTTOM


43	C
42	A1+A2
41	C
40	A1+A2
39	C
38	A1+A2

5	C
4	A1+A2
3	C
2	A1+A2
1	C

STACKING ARRANGEMENT

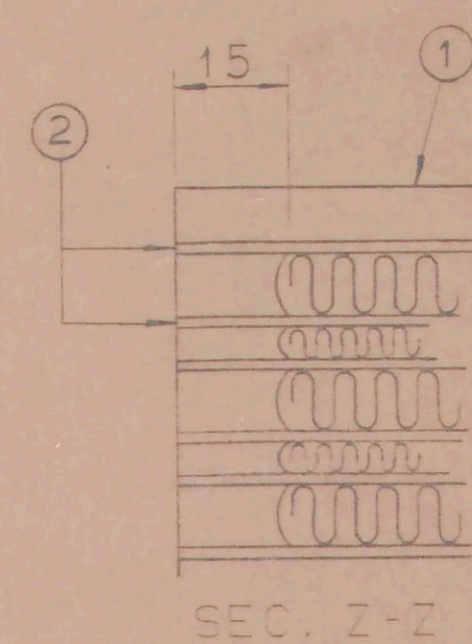


SEC. Z-Z

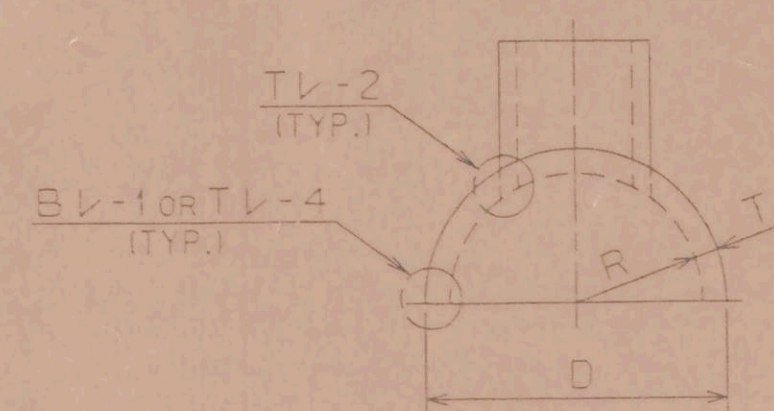

DETAIL OF HEADER TANK

ITEM NO.	R	T	D
12	48	5	106
13	140	6	292
14	38	5	86

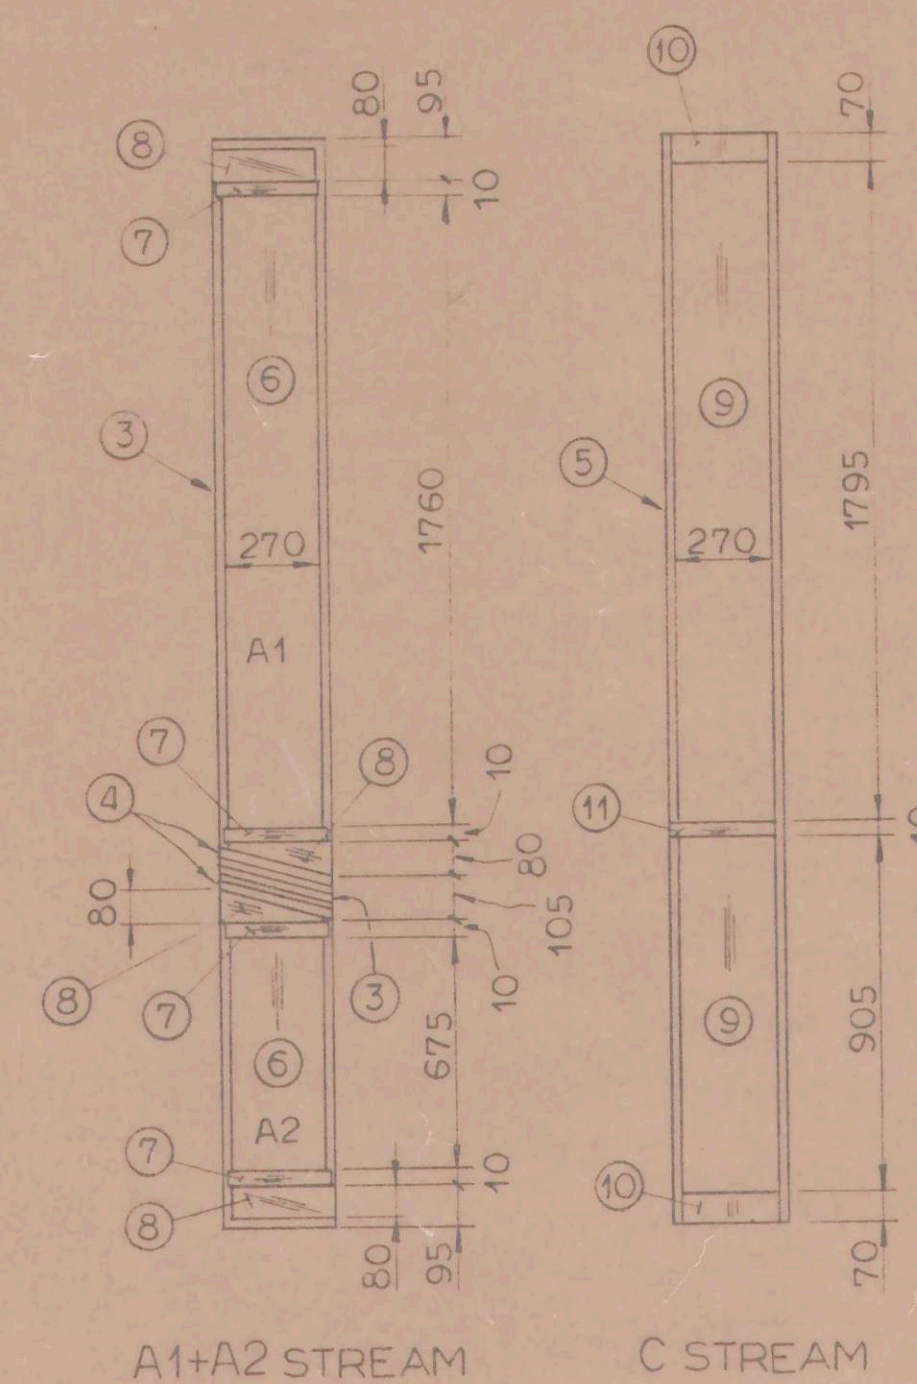

A1+A2 STREAM

C STREAM

ITEM NO.	PART NAME	MATERIAL	DESCRIPTION
(23)	NAME PLATE	SUS 304	1t
(22)	BRACKET	SB-221 6063	1t
(21)	PLATE	SB-209 5083	L=100x100x10t
(20)	PIPE	SB-241 5083	16t
(19)	END PLATE	SB-209 5083	12t
(18)	HEADER TANK	SB-209 5083	89.1φ x 5.5t 60.5φ x 3.9t
(17)	CORRUGATION	SB-209 3003	8t 8t
(16)	SPACER BAR	SB-209 3003 OR SB-221 3003	38R x 5t 140R x 6t 48R x 5t
(15)	TUBE PLATE	SFA-5.8/50.89	0.61t(350R1224/25) 0.61t(350R0624/5) 0.20t(350S1808) 0.31t(150R1412/5) 0.61t(150R1824/10) 0.20t(150S1808)
(14)	SIDE PLATE	SB-209 3003	8.89H x 15W 3.81H x 25W 3.81H x 15W
(13)	PART NAME	MATERIAL	DESCRIPTION
(12)	APPROVED	CUSTOMER	COCH PROCESS SYSTEMS, INC.
(11)	CHECKED	TITLE	MTL/ASST CRYOGENIC SYSTEMS (SSCI)
(10)	DRAWN	JOB NO.	C502066
(9)	DATE	DATE	APR 18 1991
(8)	SCALE	SCALE	1/15
(7)	3RD ANGLE PROJ.	3RD ANGLE PROJ.	ASH0669-1

配管
 材料
 二生
 外注
 二製
 現場
 現場
 品材
 品材
 鋼管
 NY
 華
 (主材)
 (物流)
 客先
 (FR+40)